

UP TO 1ST FLOOR
DOWN TO BASEMENT

ZONE 2

NOTES

- 1.00 FIRE ALARM INTERFACE UNIT AND POWER SUPPLY FOR ACCESS CONTROLLED DOOR WIRED FROM PSU IN GROUND FLOOR RISER CUPBOARD
- 2.00 SWITCHED FUSED CONNECTION UNIT AND FIRE ALARM INTERFACE UNIT IN RISER FOR EXTRACT FAN

LEGEND

- SMOKE DETECTOR
- SMOKE DETECTOR WITH SOUNDER BASE
- HEAT DETECTOR WITH SOUNDER AND BEACON BASE
- FIRE ALARM BREAK GLASS UNIT
- HEAT DETECTOR
- HEAT DETECTOR WITH SOUNDER BASE
- HEAT DETECTOR WITH SOUNDER AND BEACON BASE
- FIRE ALARM PANEL
- FIRE ALARM INTERFACE UNIT
- FIRE ALARM EQUIPMENT REFERENCE

Rev	Date	Description	By	Ckd
AB1	17-07-19	AS BUILT	JT	SW

Revisions



UNIT 11, FITZHARRIS IND EST, ABINGDON, OX14 1LD
0123559368 . 07970986310 . 07815415442

Status
AS BUILT


Client
BEARD OXFORD

Project
26 NORHAM GARDENS
OXFORD

Title
GROUND FLOOR
FIRE ALARM ZONE LAYOUT

Scale: 1:50 @ A1	Drawn J.T.	Date 06-12-18
---------------------	---------------	------------------

Drawing Number: 18/640/CJ-E303 Rev. AB1

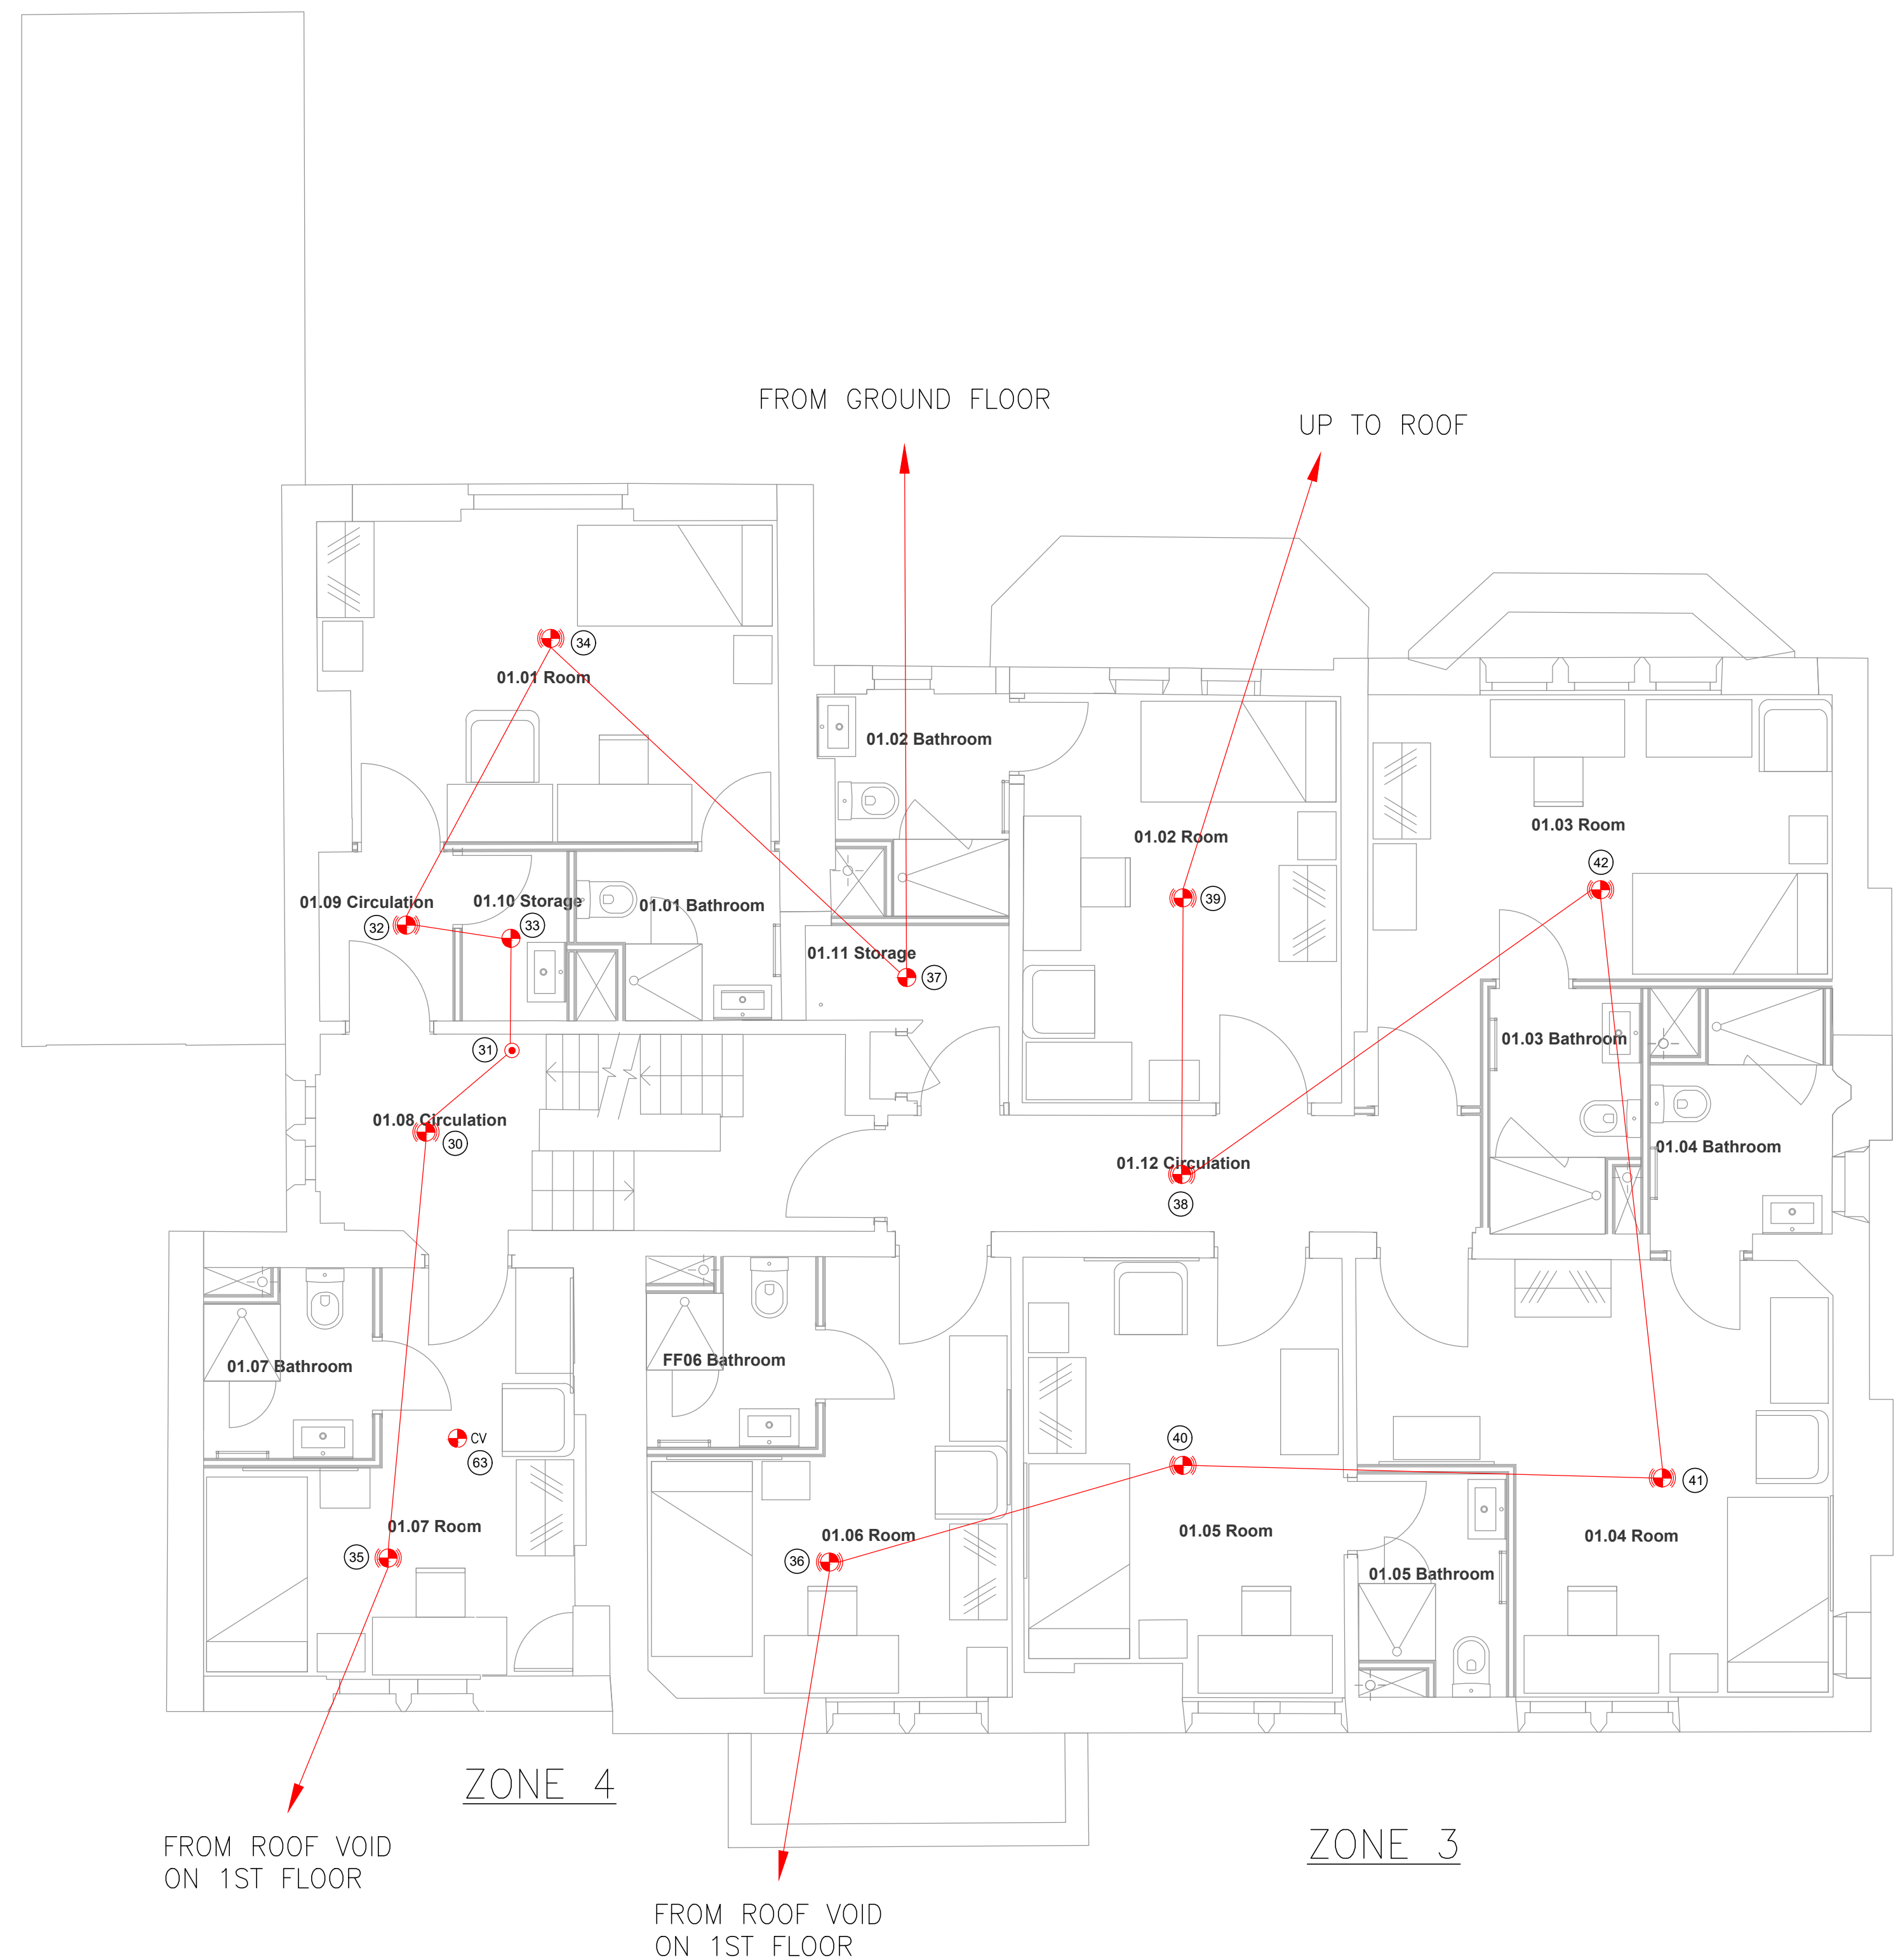

NOTES

- 1.00 FIRE ALARM INTERFACE UNIT AND POWER SUPPLY FOR ACCESS CONTROLLED DOOR WIRED FROM PSU IN GROUND FLOOR RISER CUPBOARD
- 2.00 SWITCHED FUSED CONNECTION UNIT AND FIRE ALARM INTERFACE UNIT IN RISER FOR EXTRACT FAN

LEGEND

- SMOKE DETECTOR
- SMOKE DETECTOR - CV DENOTES CEILING VOID
- SMOKE DETECTOR WITH SOUNDER BASE
- HEAT DETECTOR WITH SOUNDER AND BEACON BASE
- FIRE ALARM BREAK GLASS UNIT
- HEAT DETECTOR
- HEAT DETECTOR WITH SOUNDER BASE
- HEAT DETECTOR WITH SOUNDER AND BEACON BASE
- FIRE ALARM PANEL
- FIRE ALARM INTERFACE UNIT
- FIRE ALARM EQUIPMENT REFERENCE

Rev	Date	Description	By	Ckd
AB1	17-07-19	AS BUILT	JT	SW

Revisions



UNIT 11, FITZHARRIS IND EST, ABINGDON, OX14 1LD
01235559368 . 07970986310 . 07815415442

Status
AS BUILT


Client
BEARD OXFORD

Project
**26 NORHAM GARDENS
OXFORD**

Title
**FIRST FLOOR
FIRE ALARM ZONE LAYOUT**

Scale: 1:50 @ A1	Drawn J.T.	Date 06-12-18
---------------------	---------------	------------------

Drawing Number: **18/640/CJ-E403** Rev. **AB1**

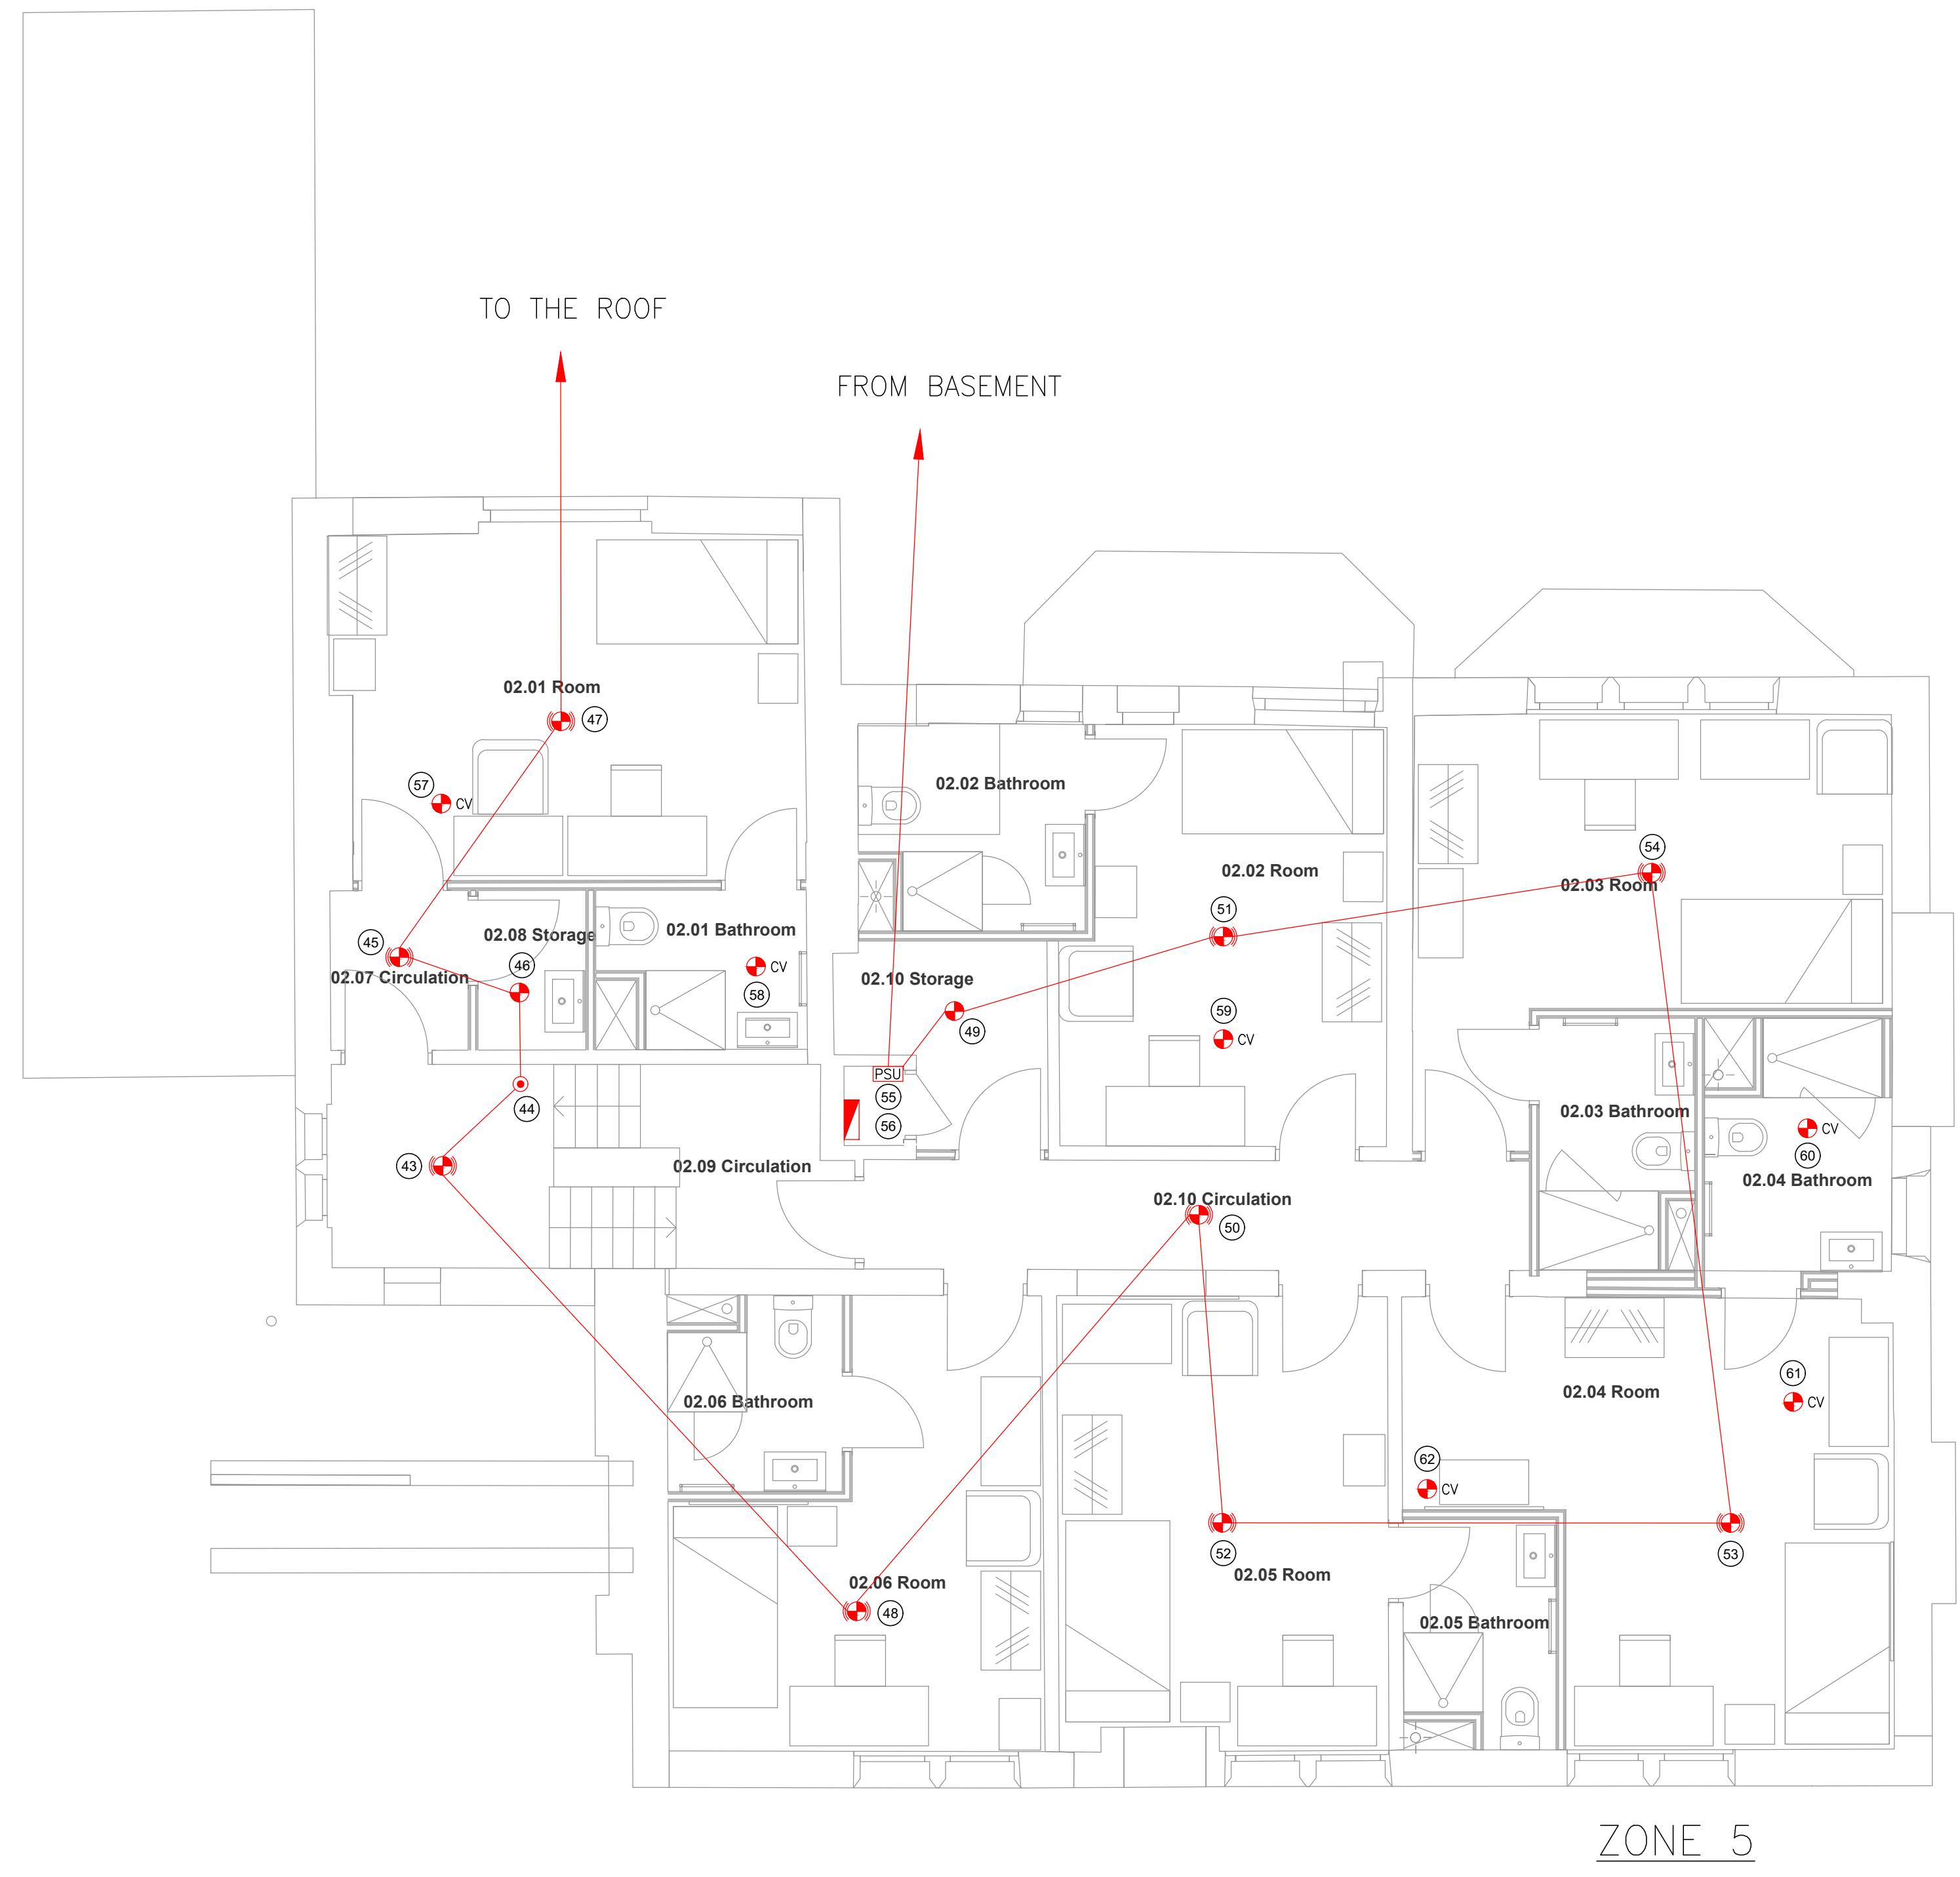

NOTES

- 1.00 FIRE ALARM INTERFACE UNIT AND POWER SUPPLY FOR ACCESS CONTROLLED DOOR WIRED FROM PSU IN GROUND FLOOR RISER CUPBOARD
- 2.00 SWITCHED FUSED CONNECTION UNIT AND FIRE ALARM INTERFACE UNIT IN RISER FOR EXTRACT FAN

LEGEND

- SMOKE DETECTOR
- SMOKE DETECTOR - CV DENOTES CEILING VOID
- SMOKE DETECTOR WITH SOUNDER BASE
- HEAT DETECTOR WITH SOUNDER AND BEACON BASE
- FIRE ALARM BREAK GLASS UNIT
- HEAT DETECTOR
- HEAT DETECTOR WITH SOUNDER BASE
- HEAT DETECTOR WITH SOUNDER AND BEACON BASE
- FIRE ALARM PANEL
- FIRE ALARM INTERFACE UNIT
- FIRE ALARM EQUIPMENT REFERENCE

Rev	Date	Description	By	Ckd
AB1	17-07-19	AS BUILT	JT	SW

Revisions



Status

AS BUILT

Client

BEARD OXFORD

Project

26 NORHAM GARDENS
OXFORD

Title

SECOND FLOOR
FIRE ALARM ZONE LAYOUT

Scale:	Drawn	Date
1:50 @ A1	J.T.	06-12-18

Drawing Number:	Rev.
18/640/CJ-E503	AB1